




LEGEND
 = CUT
 = FILL



P.O. #1


Mound #1

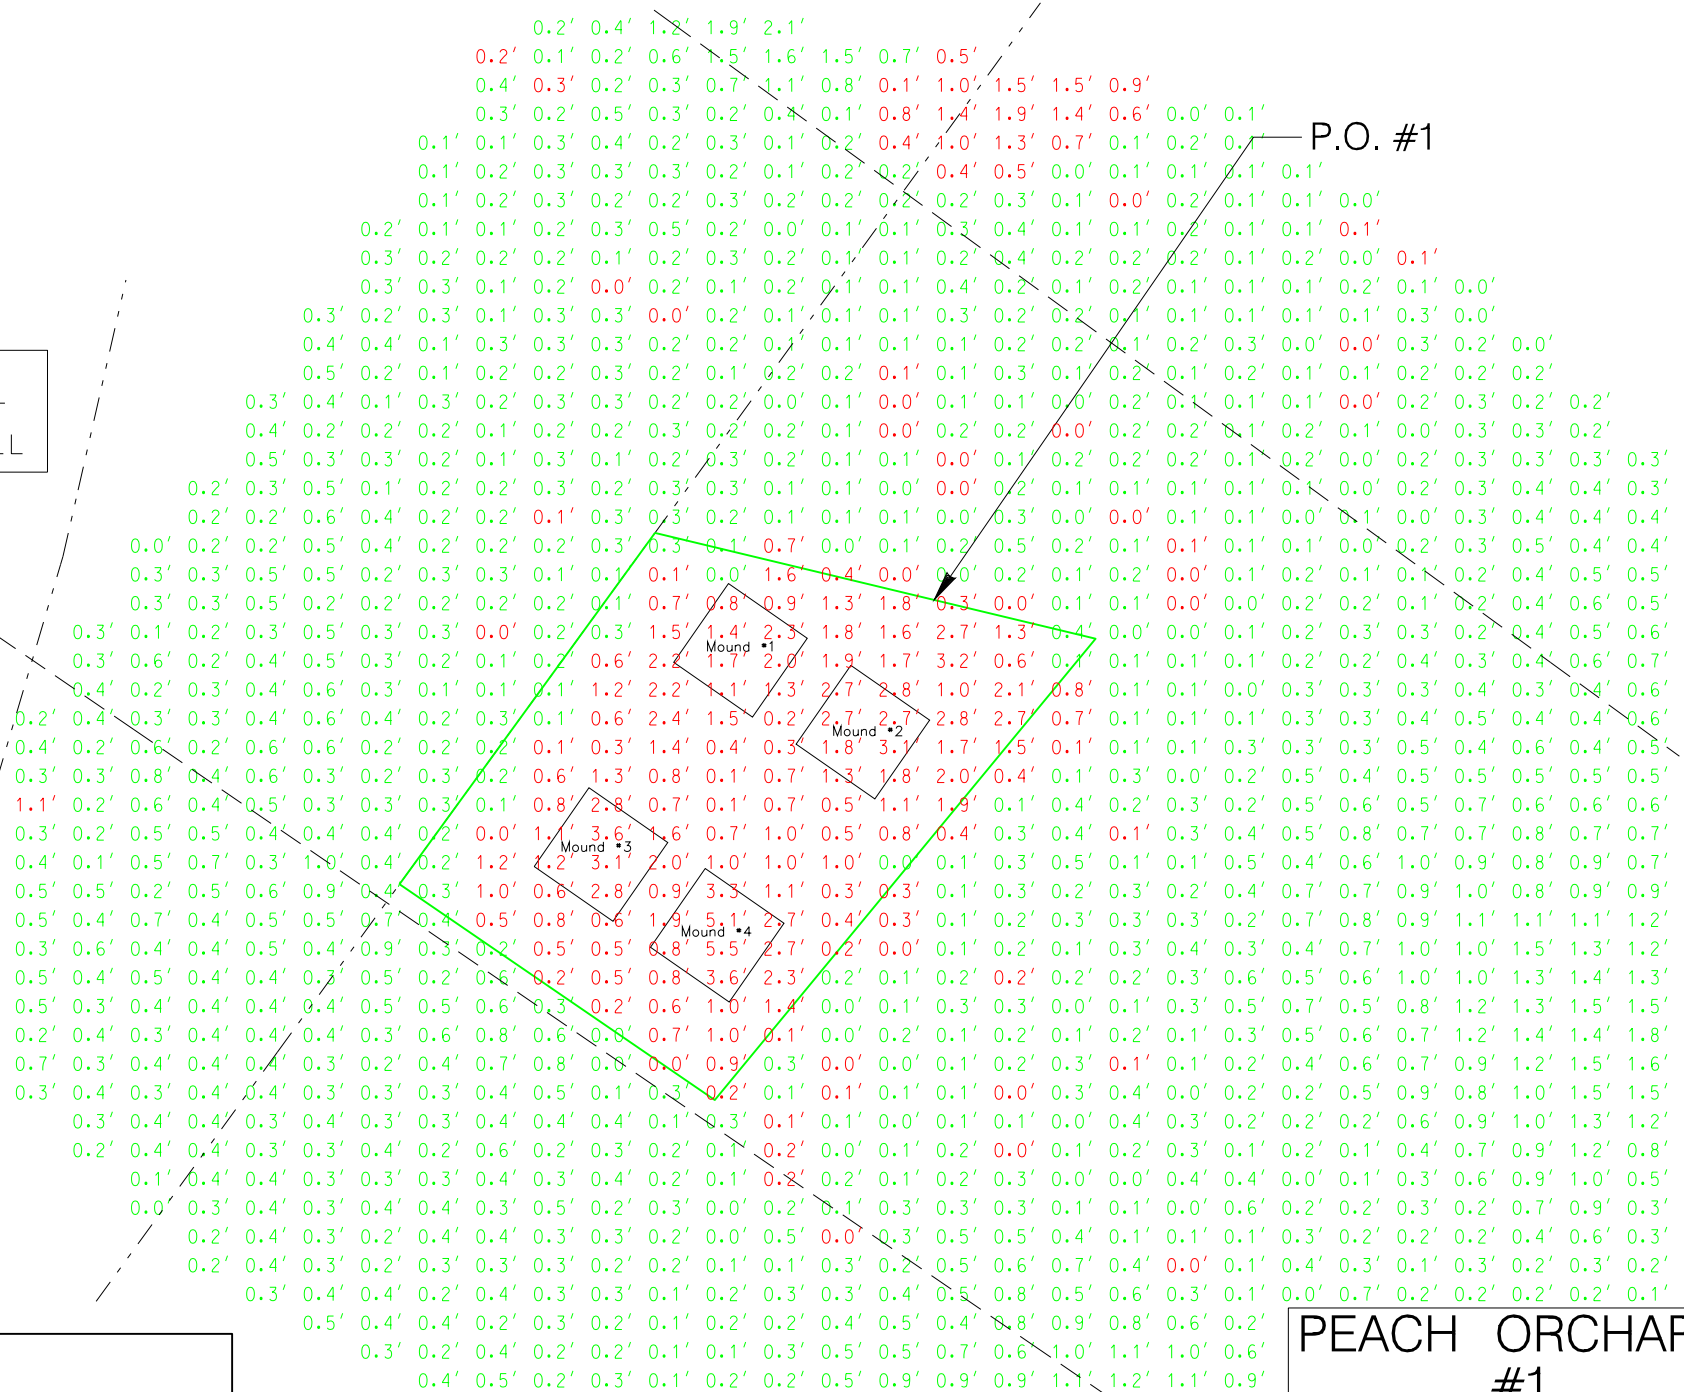Mound #2

Mound #3

Mound #4

PEACH ORCHARD #1

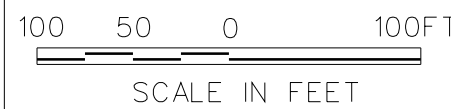


Note:
Peach Orchard #1
1,018 cubic yards of granite
placed Nov-Dec 2009.



LEGEND

= CUT

= FILL

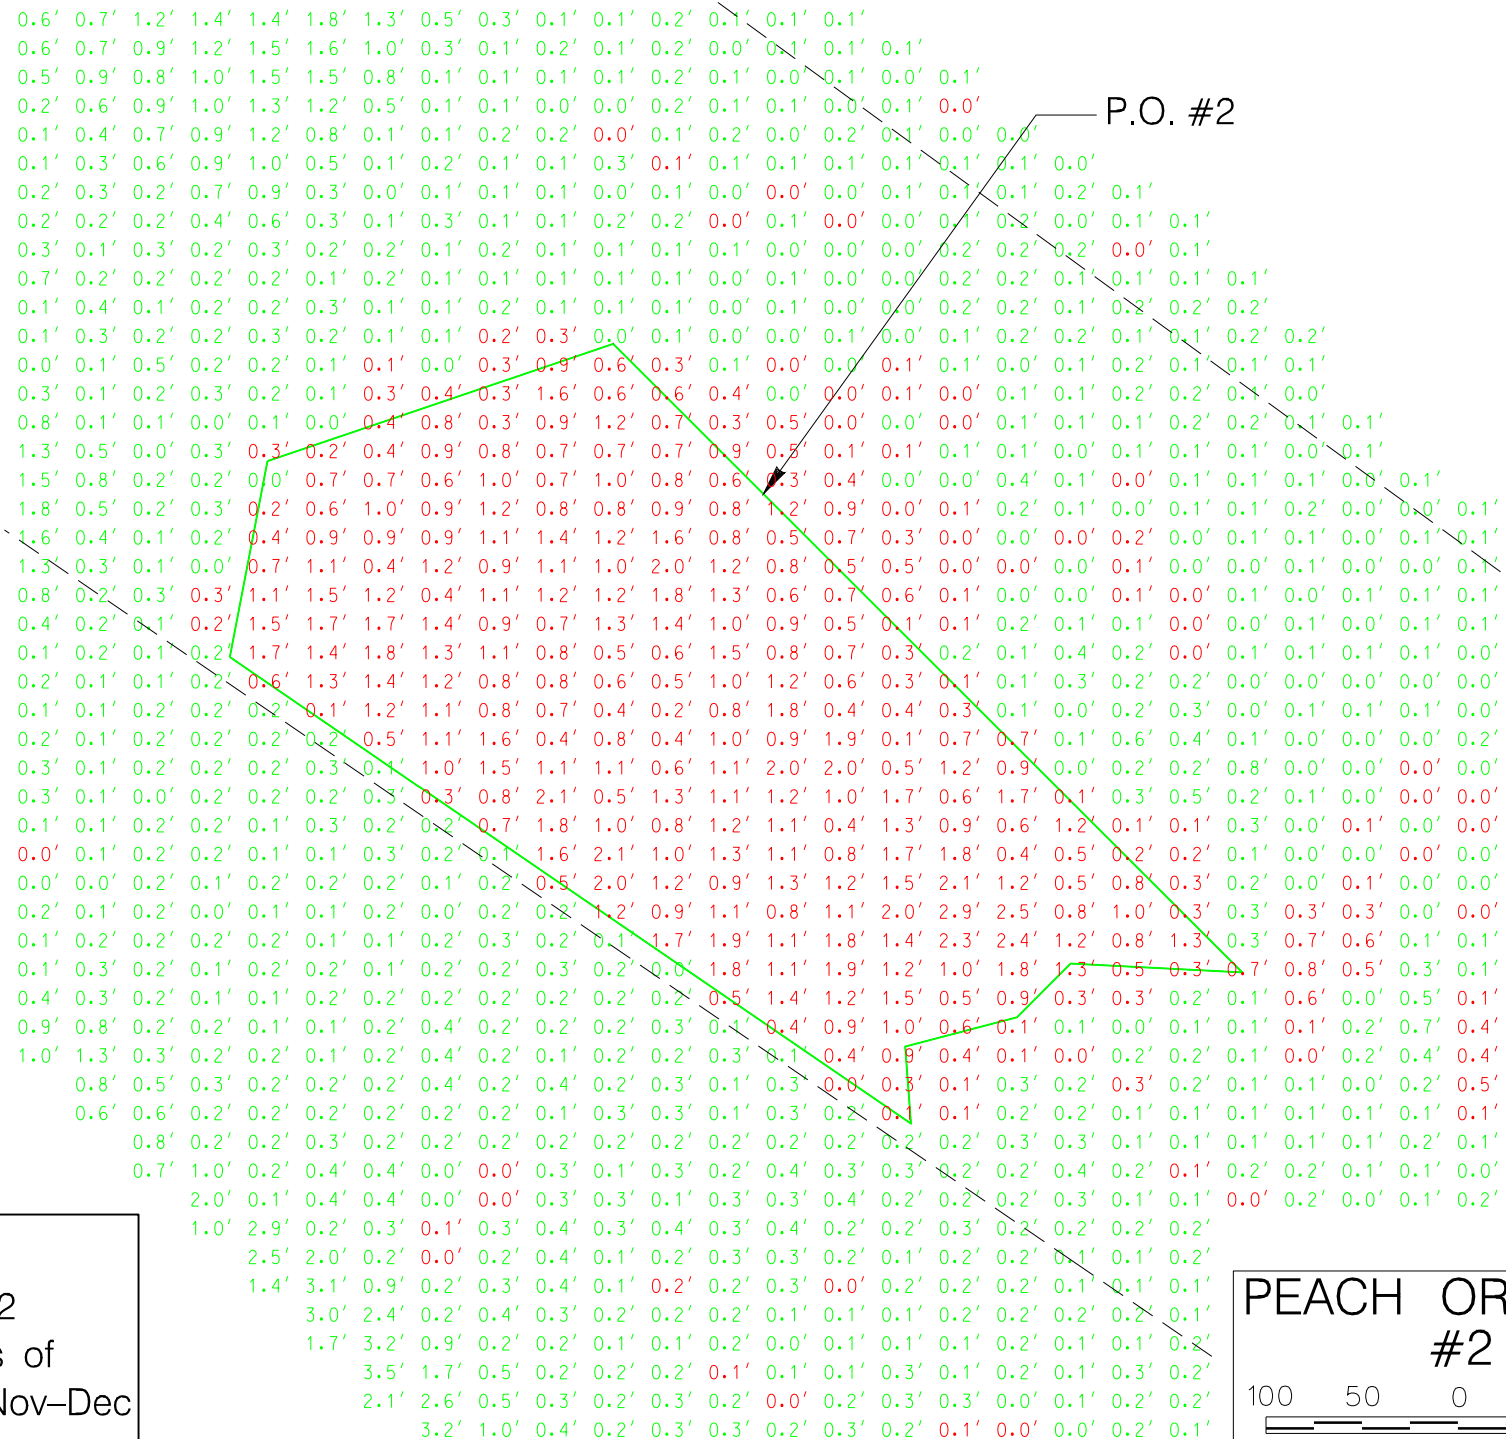


Note:

Peach Orchard #2
 4861 cubic yards of
 granite placed Nov-Dec
 2009.

PEACH ORCHARD #2

100 50 0 100FT


SCALE IN FEET

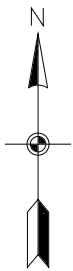

LEGEND

= CUT

= FILL

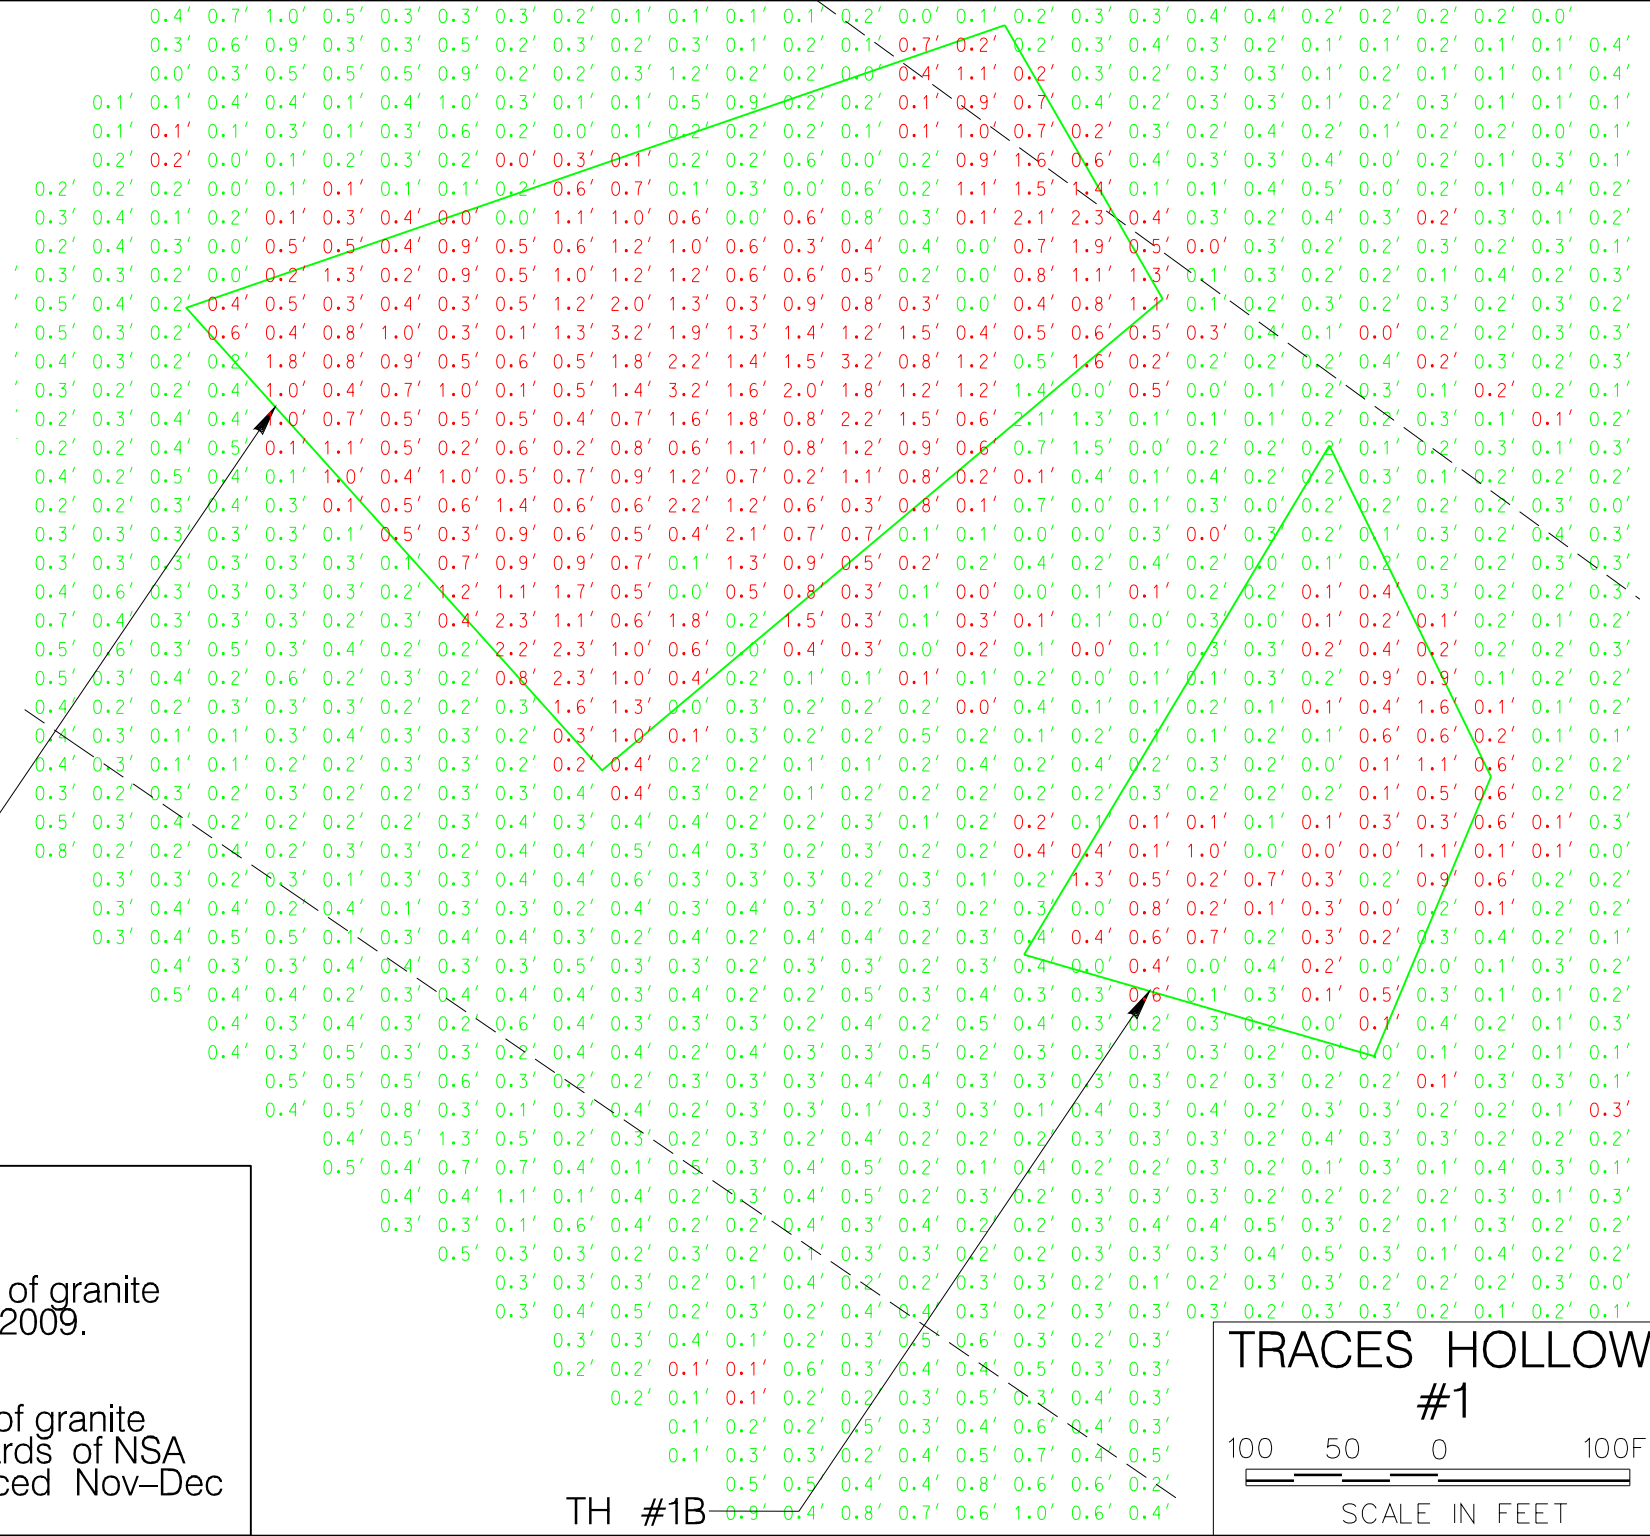

TH #1A

TH #1B

TRACES HOLLOW #1

100 50 0 100FT

SCALE IN FEET

Notes:



Traces Hollow #1A
4185 cubic yards of granite
placed Nov-Dec 2009.

Traces Hollow #1B
337 cubic yards of granite
and 214 cubic yards of NSA
concrete tiles placed Nov-Dec
2009.

Note:
 Traces Hollow #2A
 3352 cubic yards of
 granite placed Nov-Dec
 2009.

LEGEND

█ = CUT
█ = FILL

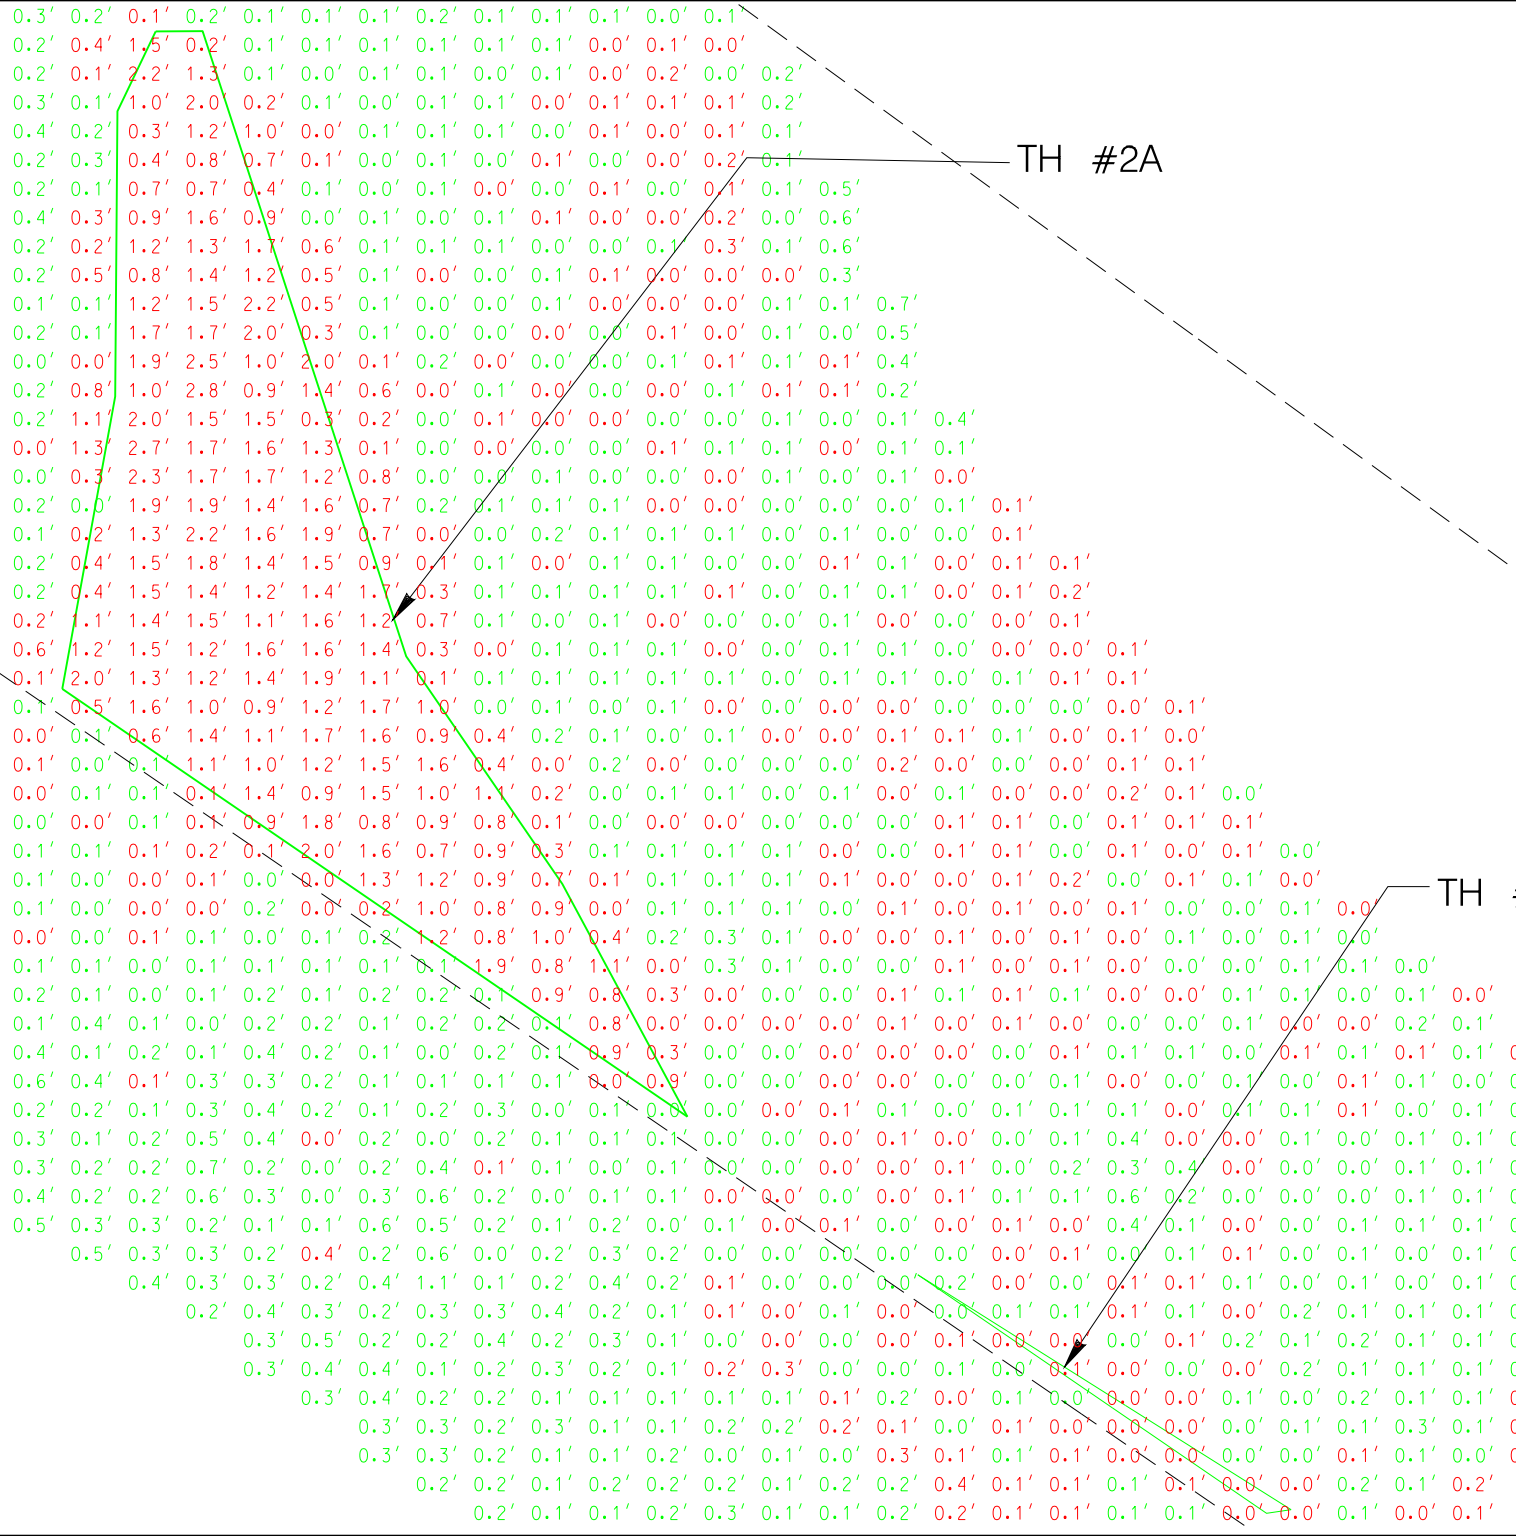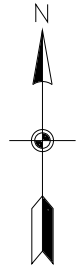




TRACES HOLLOW
 #2

100 50 0 100FT


SCALE IN FEET




LEGEND
 = CUT
 = FILL

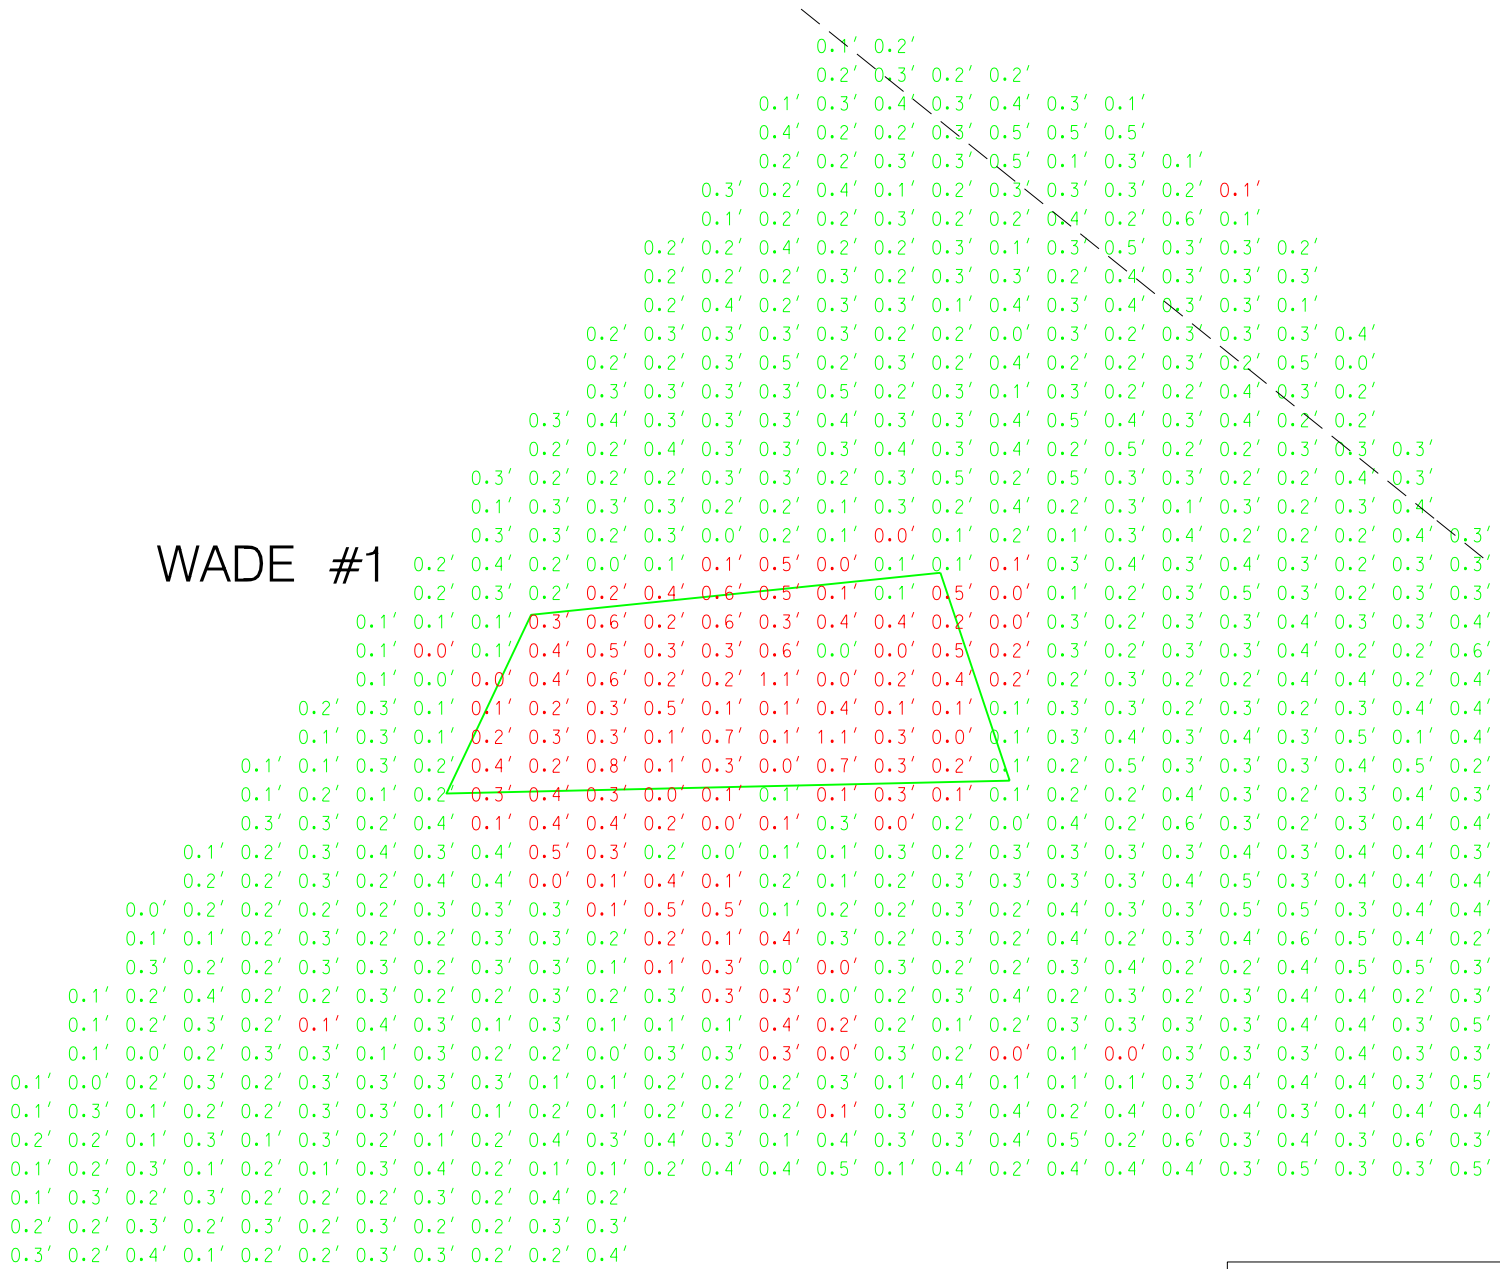


Note:
Wade #1
996 cubic yards of concrete
placed Nov-Dec 2009.

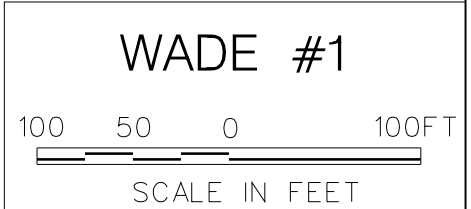

WD #2
#3

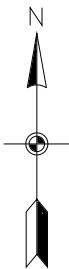

LEGEND
 = CUT
 = FILL

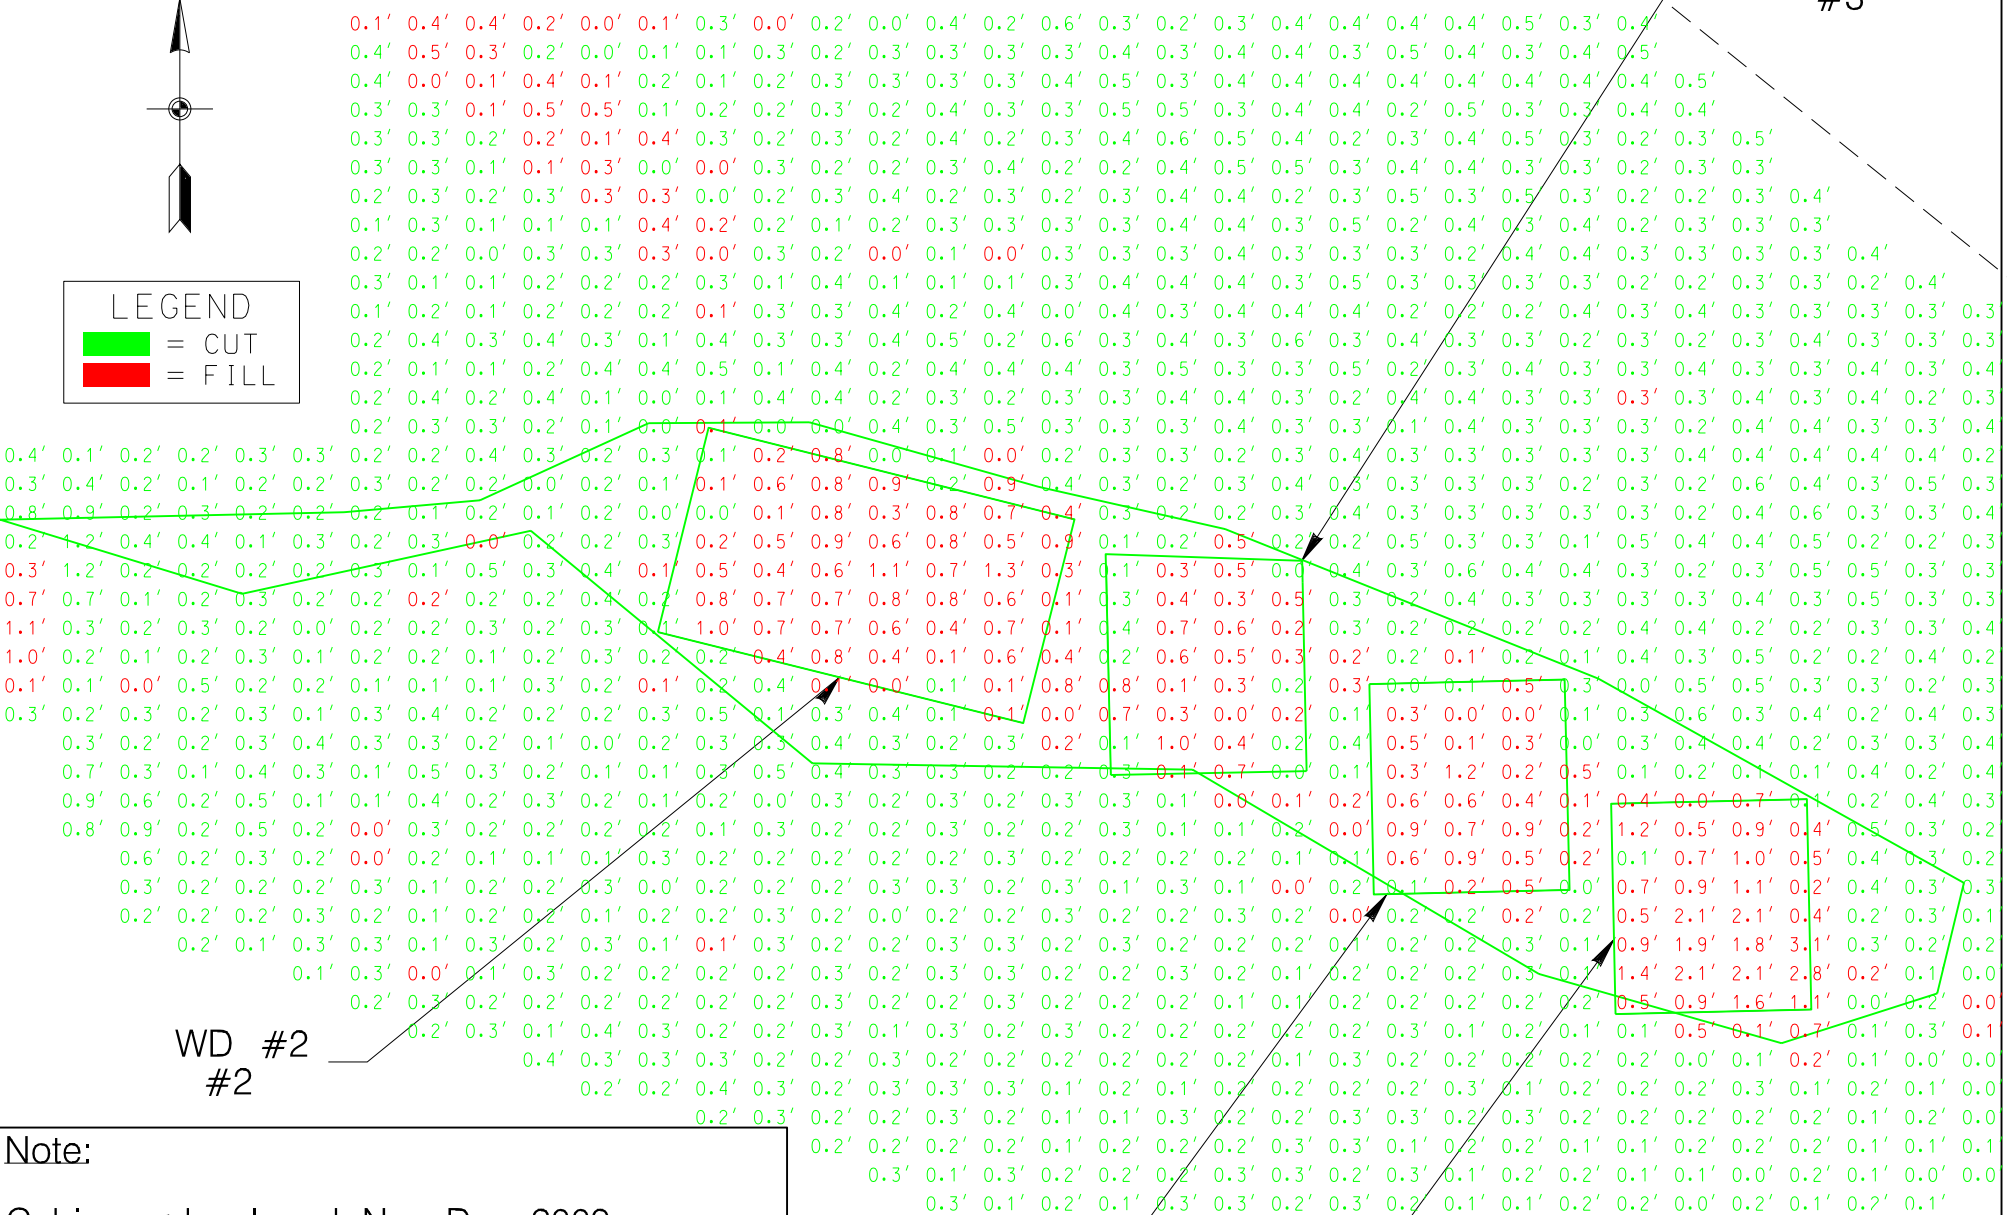

Note:
Cubic yards placed Nov-Dec 2009

	Granite	Concrete	Steel Slag
#2	322	161	322
#3	0	0	403
#4	0	403	0
#5	696	0	0

WD #2
#4

WD #2
#5


WADE #2


SCALE IN FEET


Note:

Weems Upper
5,743 cubic yards of granite
and 1,530 cubic yards of shell
veneer placed Nov-Dec 2009.

LEGEND

 = CUT

 = FILL

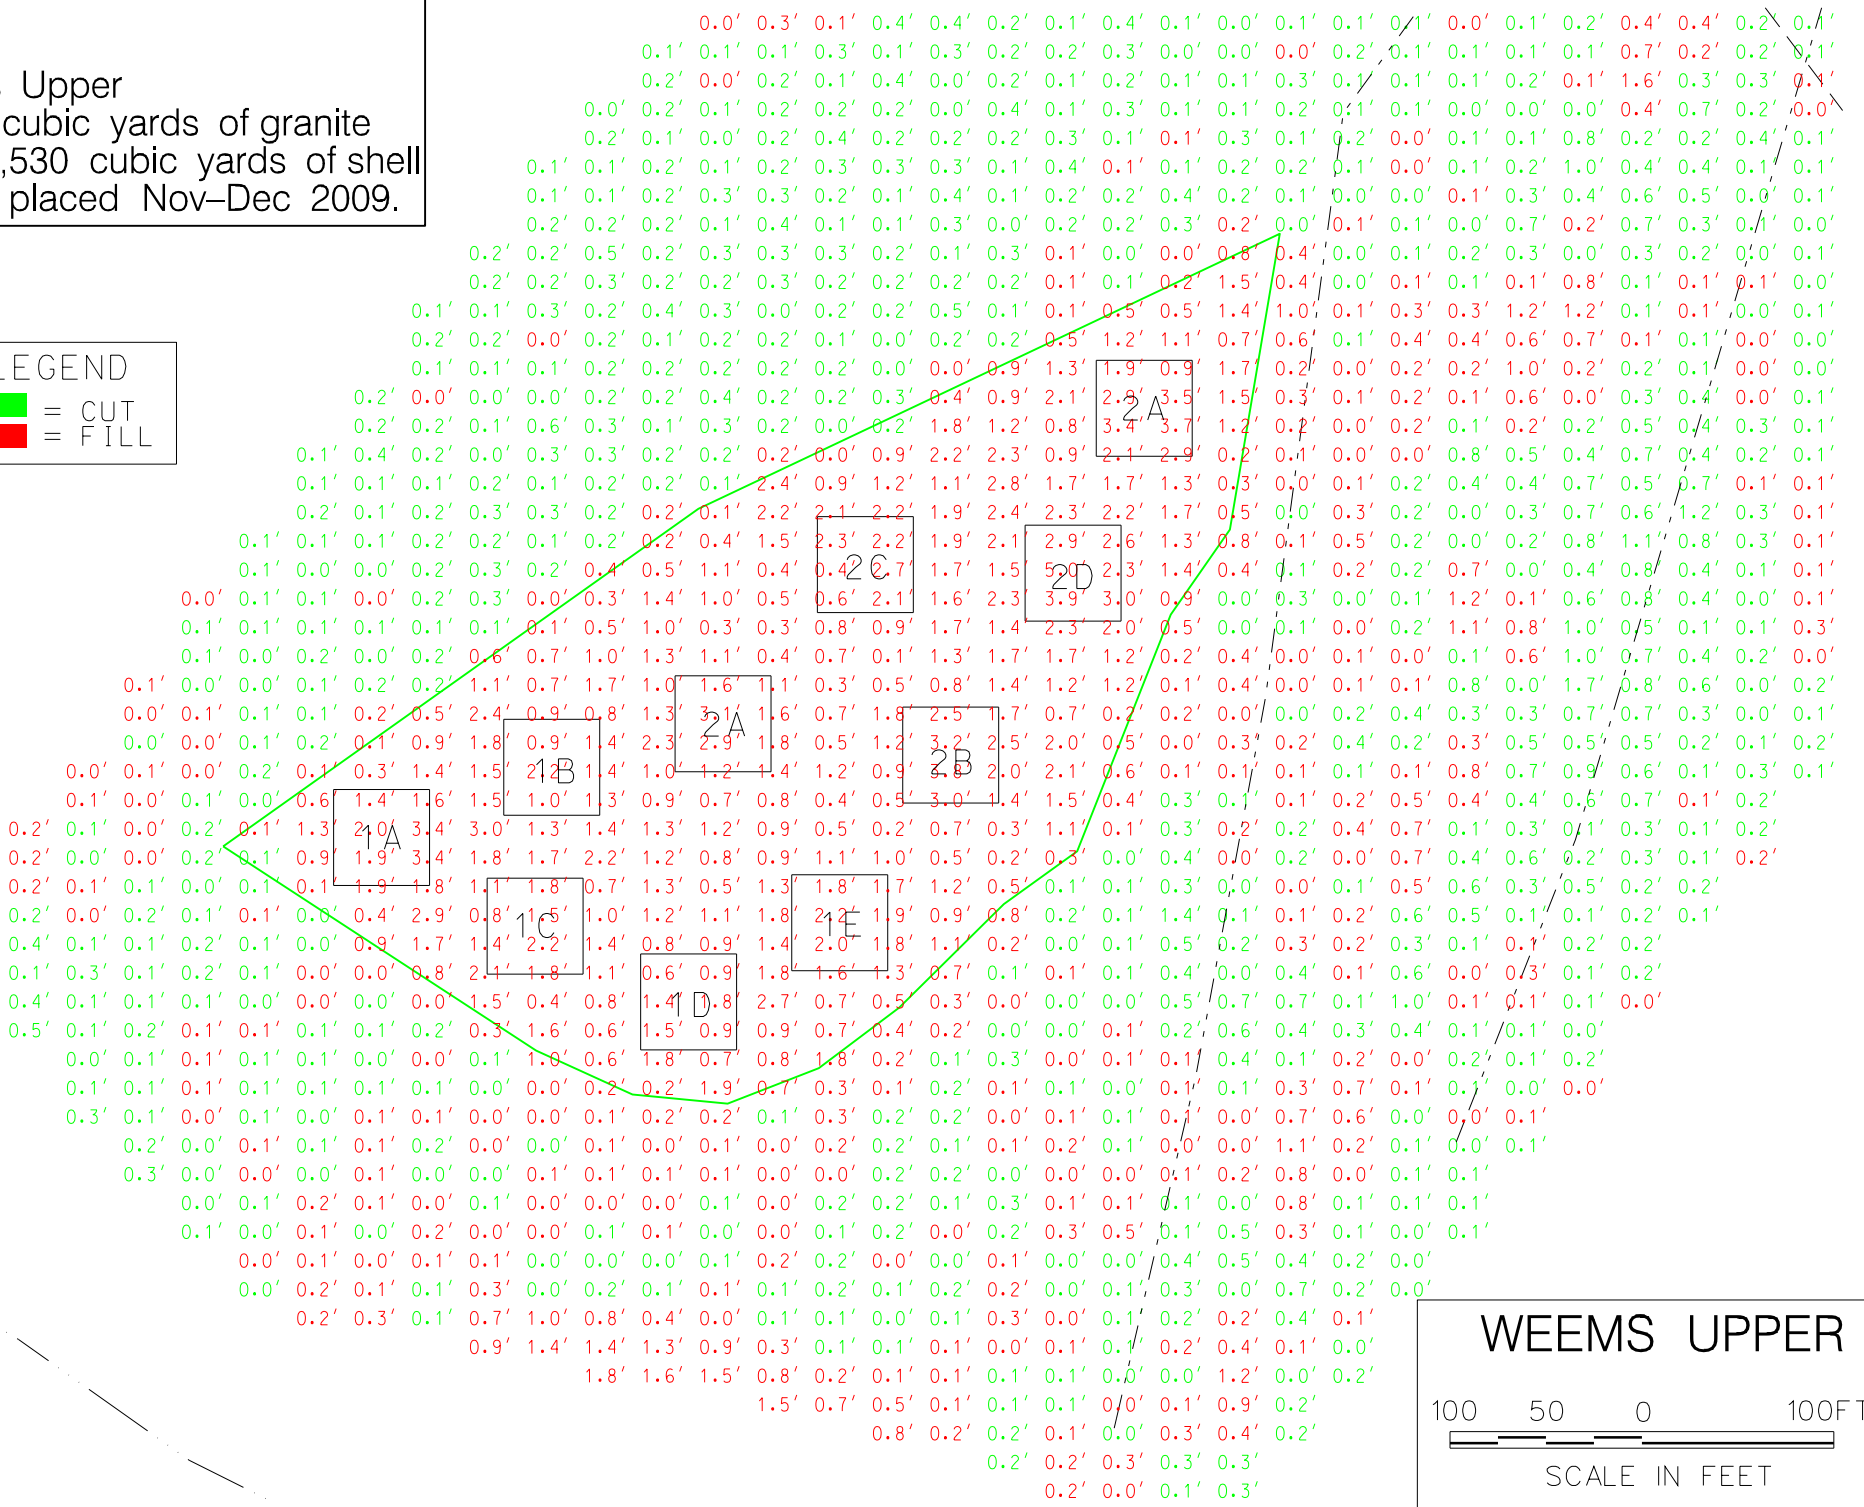

WEEMS UPPER

100 50 0 100 FT

SCALE IN FEET